




LUXURY RETAIL SPACE FOR LEASE

243 WORTH AVENUE

Palm Beach, Florida 33480

“AS-BUILT”

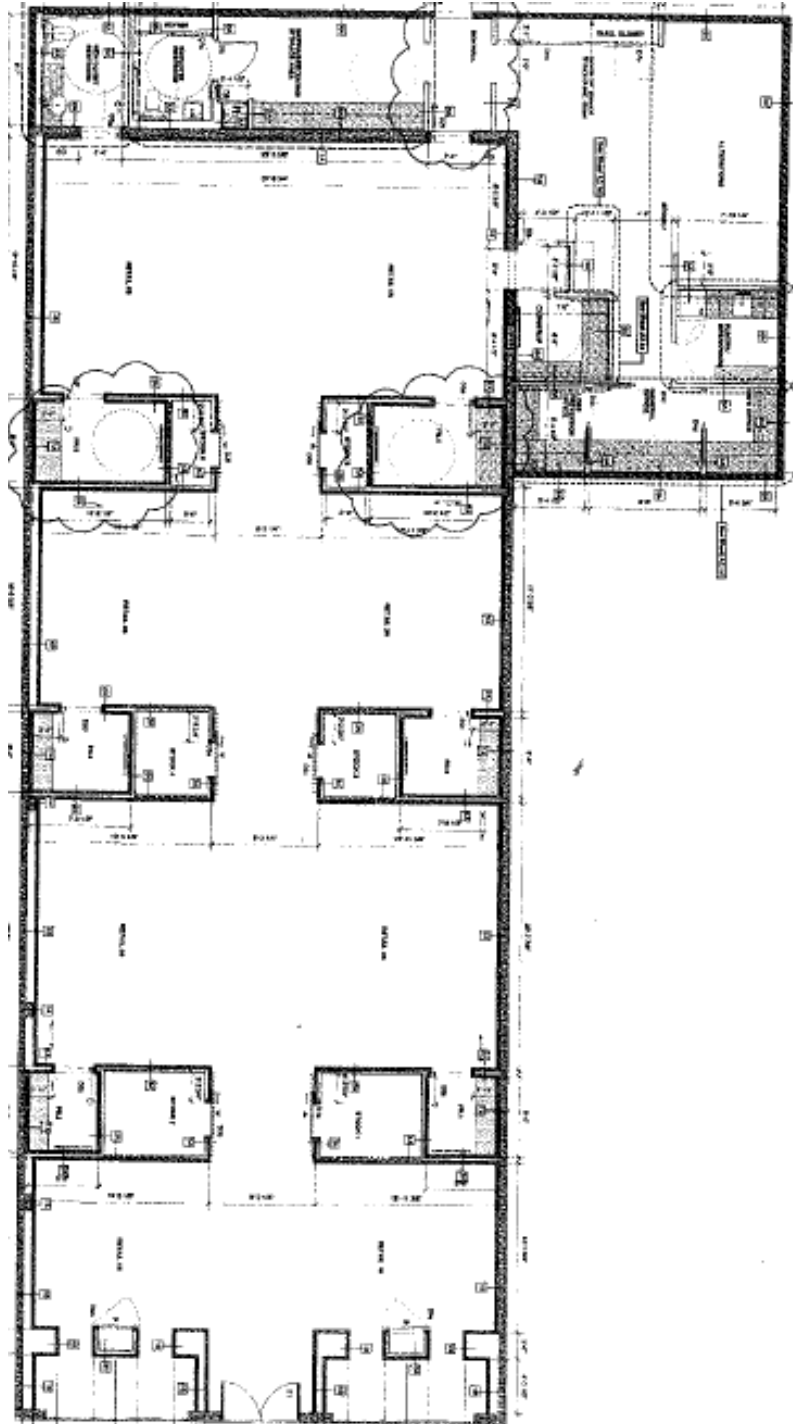

4,878 RSF

* NOT TO SCALE

WORTH AVENUE

For more information, please contact:

Robert Klecinsky
+1 561 227 2671
robert.klecinsky@cushwake.com

303 Banyan Boulevard, Suite 301
West Palm Beach, FL 33410
+1 561 227 2020
cushmanwakefield.com